




Column I/11, 60/60, M1:50
Slip I/11, 60/60, M1:50

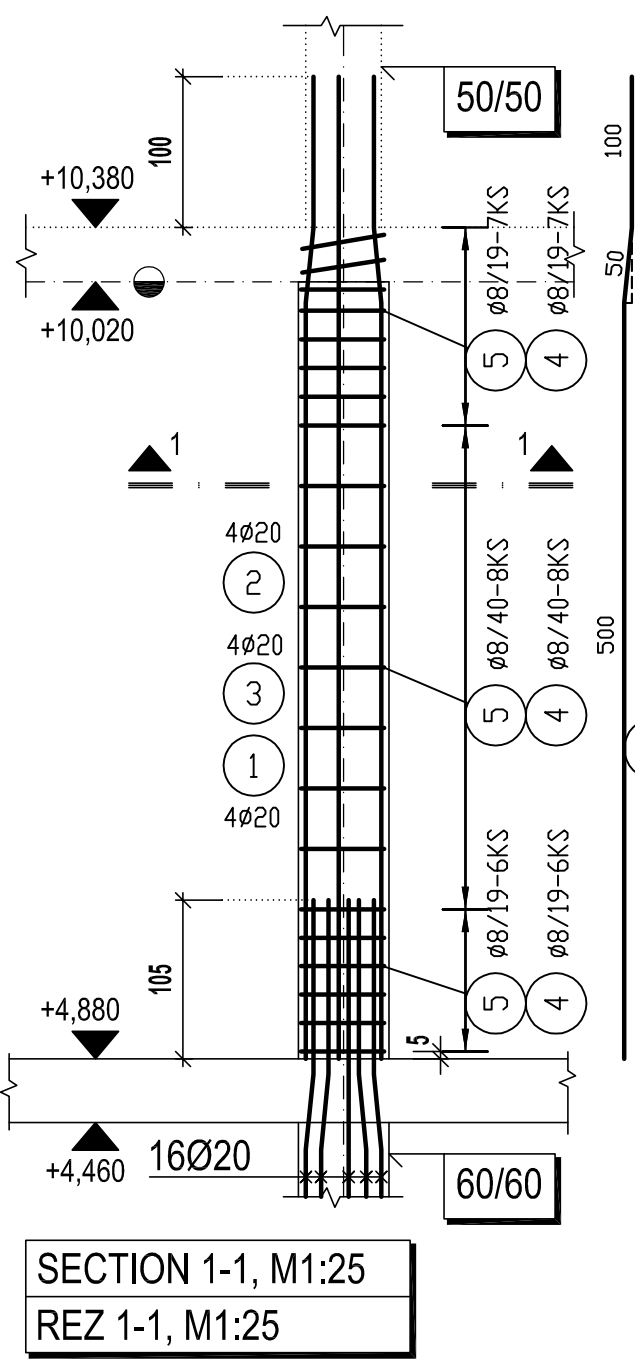


Column I/12, 60/60, M1:50
Slip I/12, 60/60, M1:50

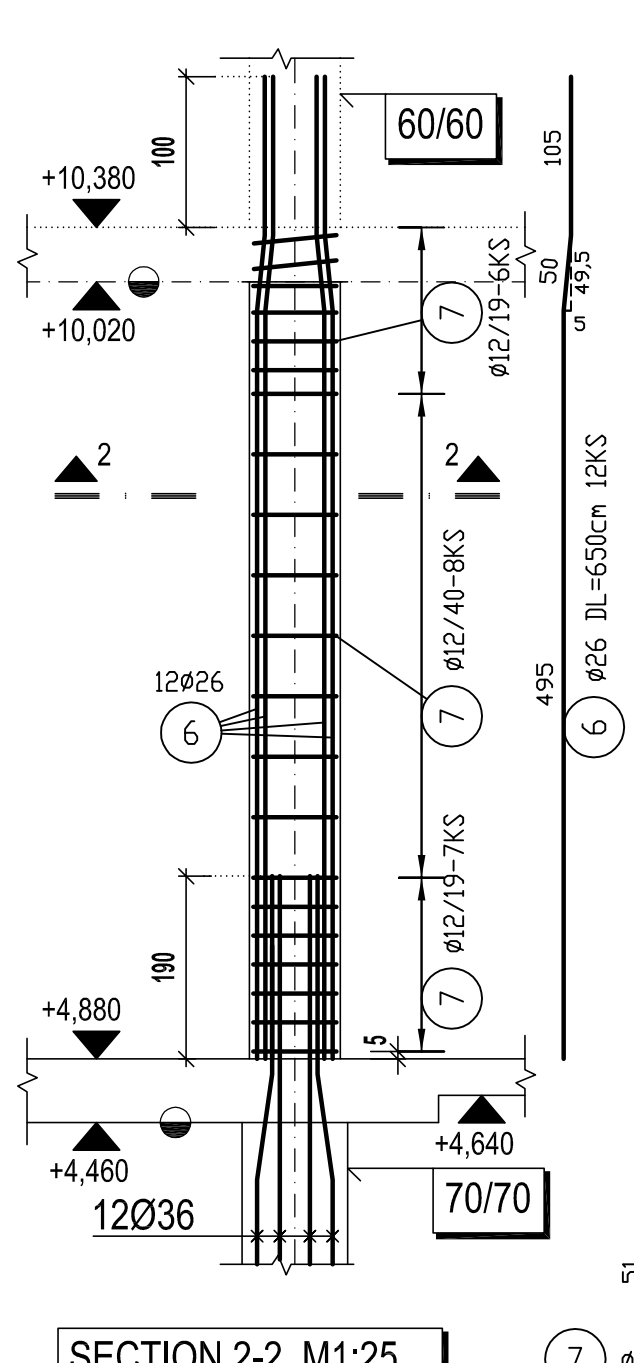


Column I/13, 60/60, M1:50
Slip I/13, 60/60, M1:50

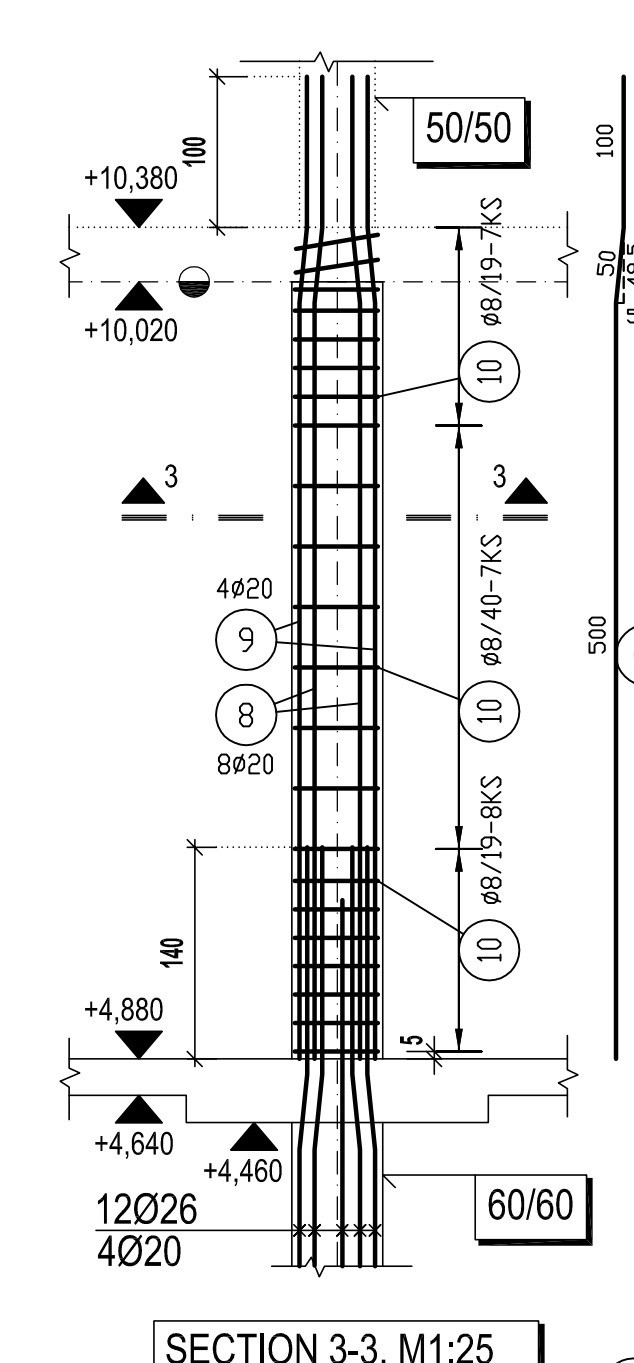


Column I/15, I/16, J/15, J/16, 60/60, M1:50
Slip I/15, I/16, 60/60, J/15, J/16, M1:50

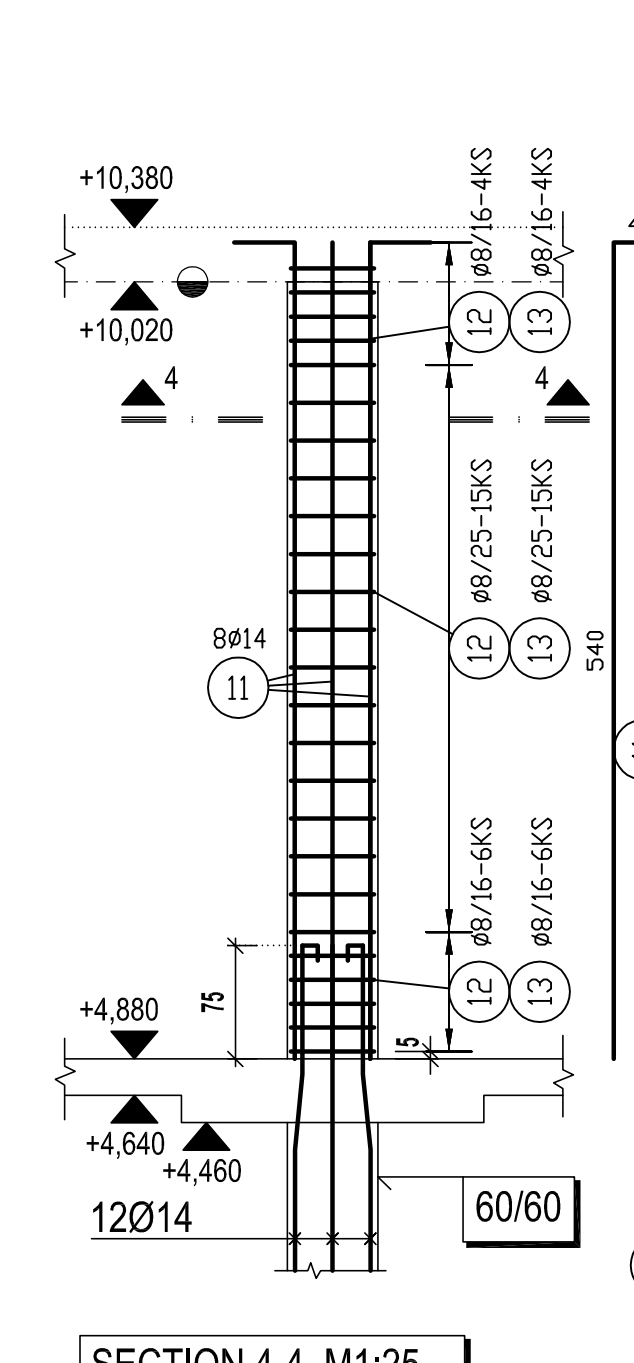


Column I/19, 60/60, M1:50
Slip I/19, 60/60, M1:50

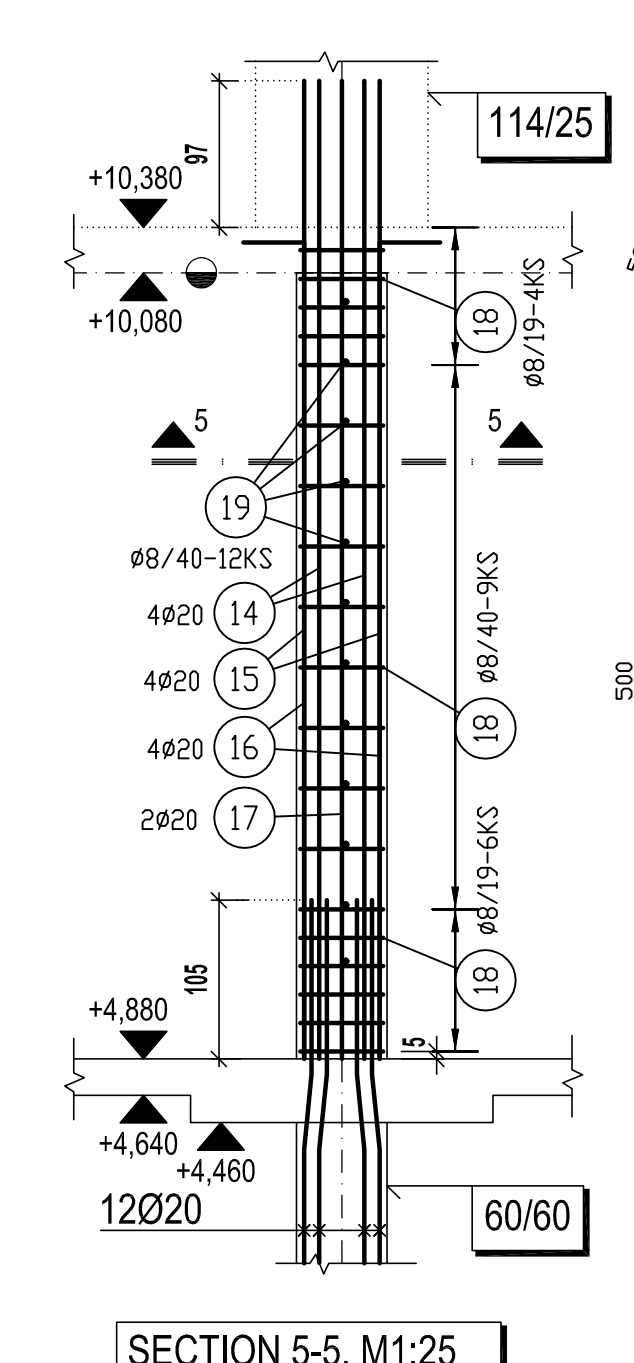


Column I/20-21, Ø70, M1:50
Slip I/20-21, Ø70, M1:50

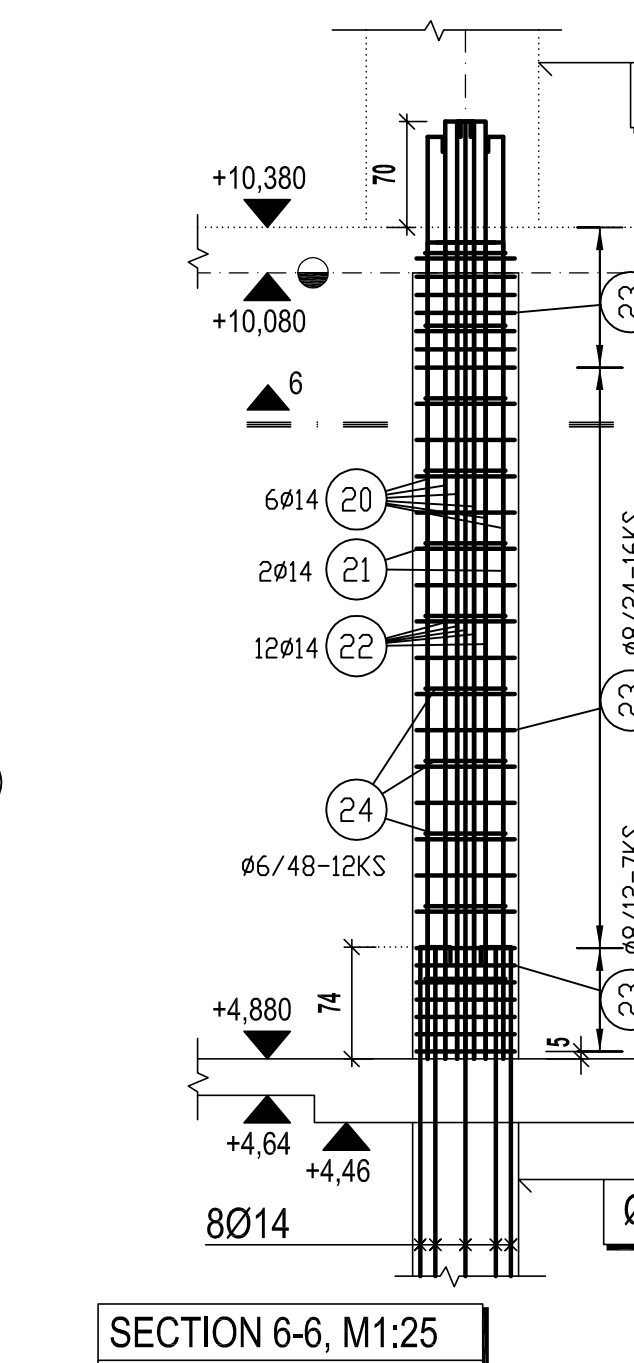


Column J/11, 60/60, M1:50
Slip J/11, 60/60, M1:50

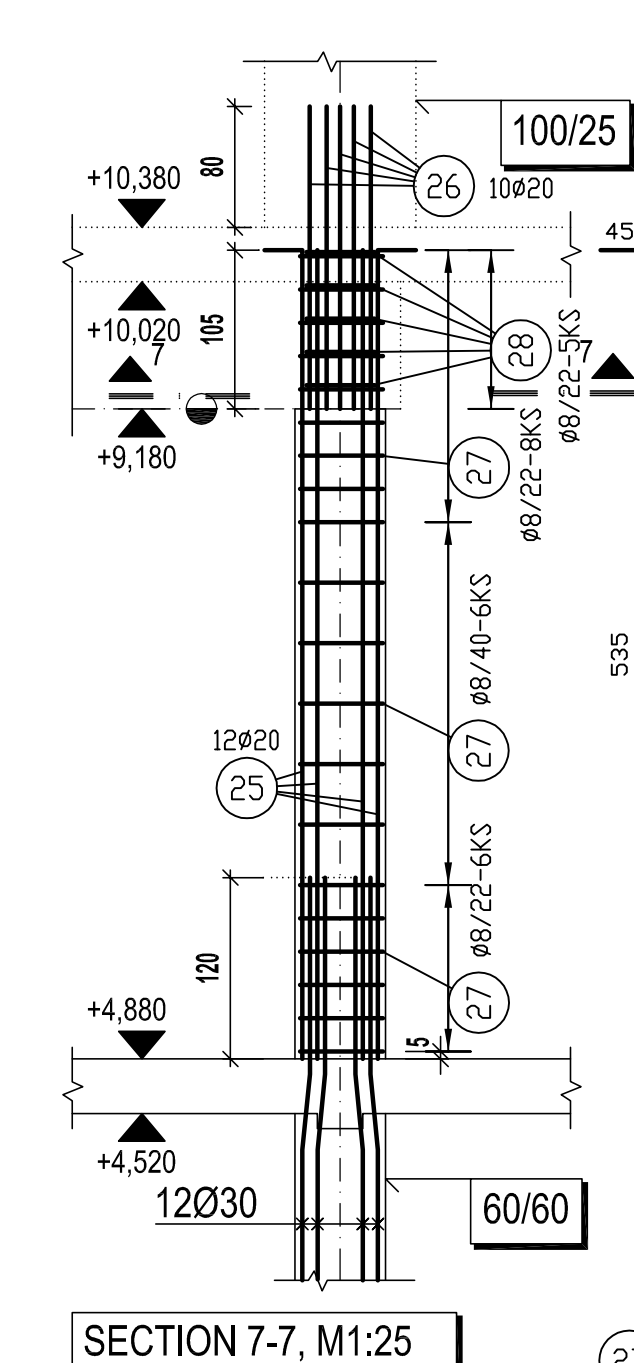


SO-03 Ground plan scheme of columns L1 - Plan number 001
SO-03 Pódorysná schéma rozmiestnenia stĺpov L1 - výkres číslo 001

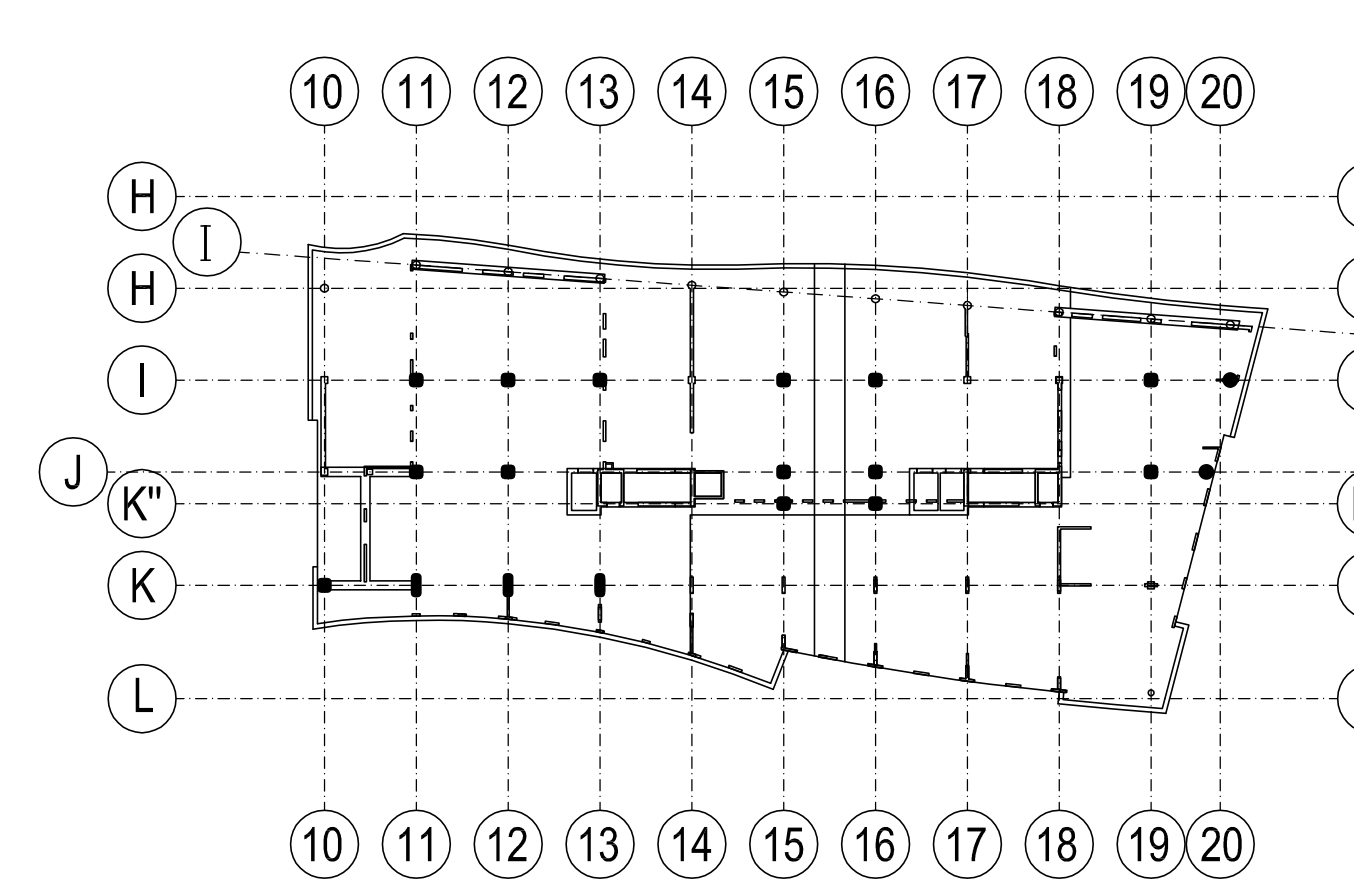


Column J/12, 60/60, M1:50
Slip J/12, 60/60, M1:50

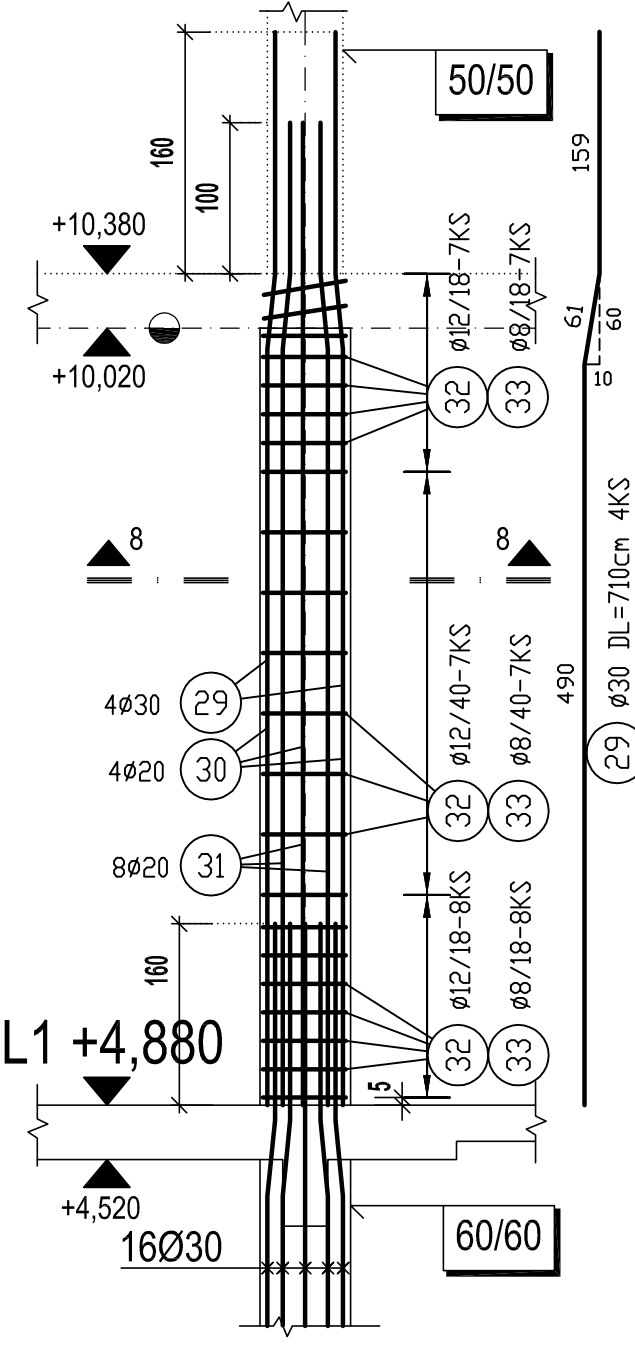


Column J/19, 60/60, M1:50
Slip J/19, 60/60, M1:50

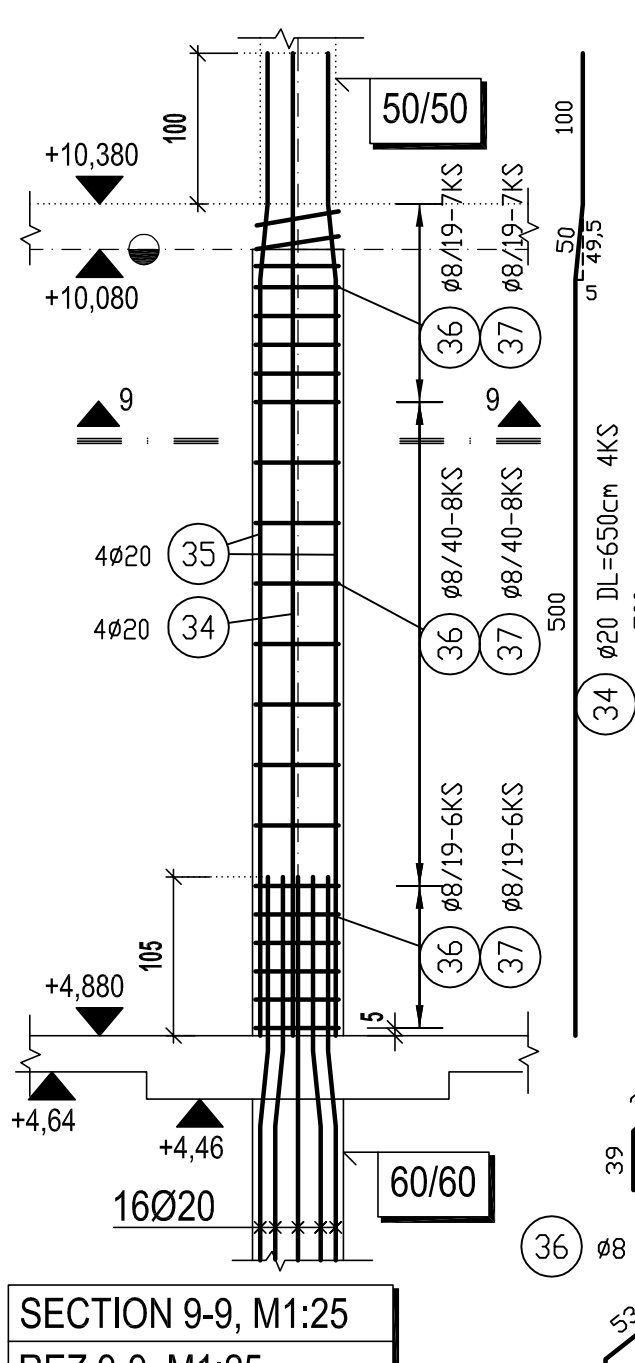


Column J/19-20, Ø70, M1:50
Slip J/19-20, Ø70, M1:50

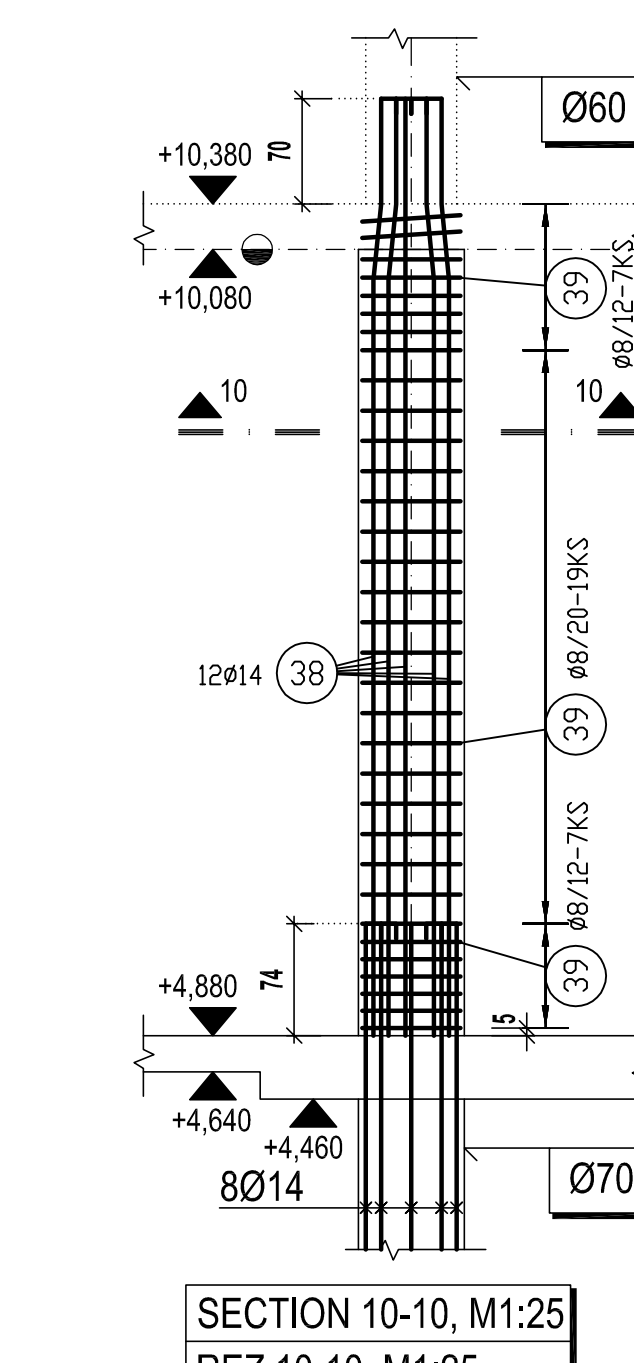


Column K/15, 60/60, M1:50
Slip K/15, 60/60, M1:50

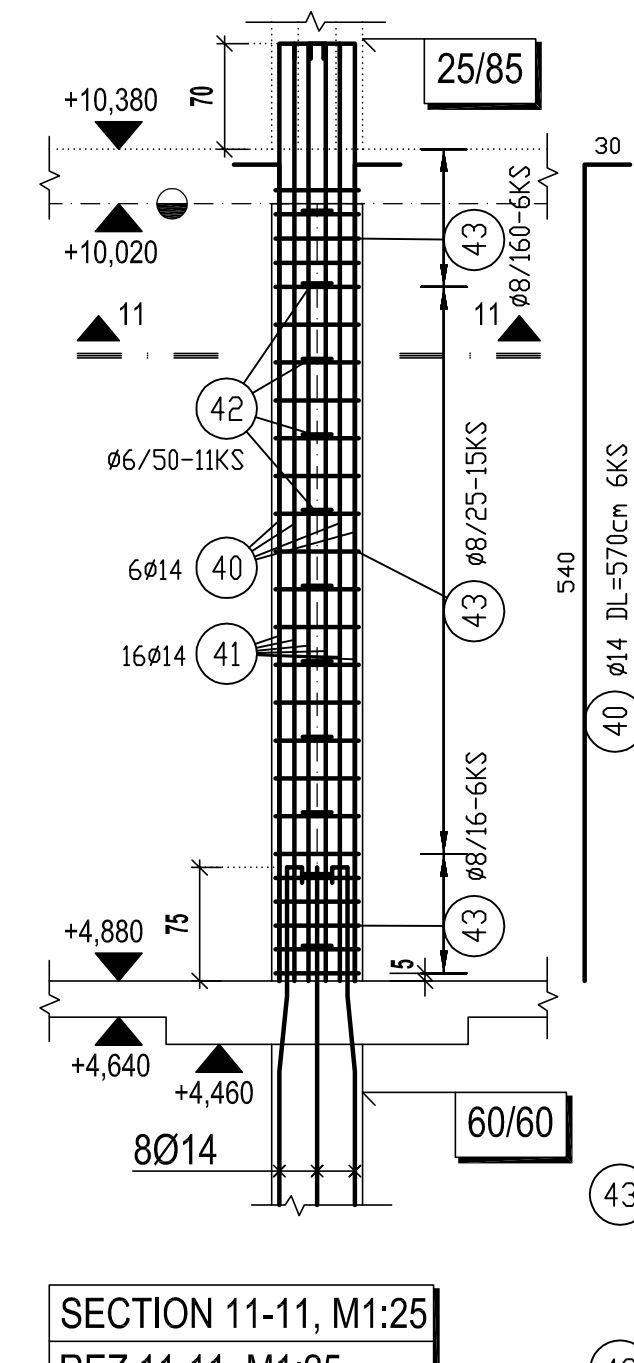

Column K/16, 60/60, M1:50
Slip K/16, 60/60, M1:50

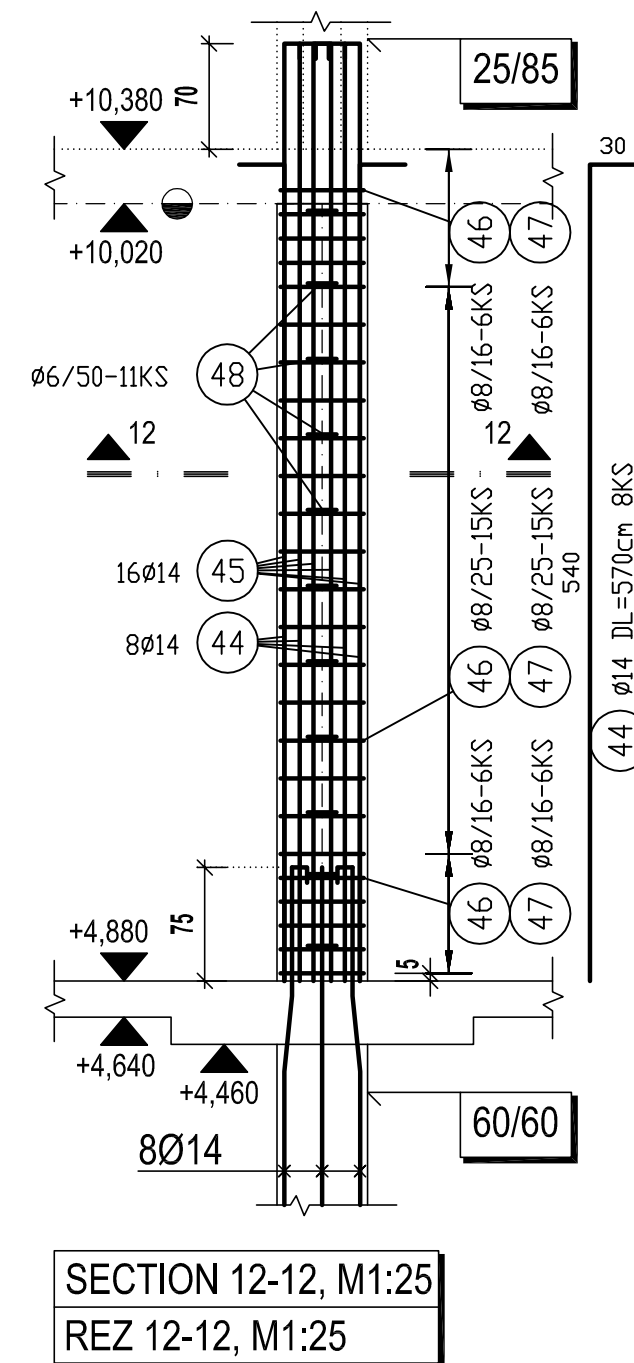

Column K/10, 60/60, M1:50
Slip K/10, 60/60, M1:50

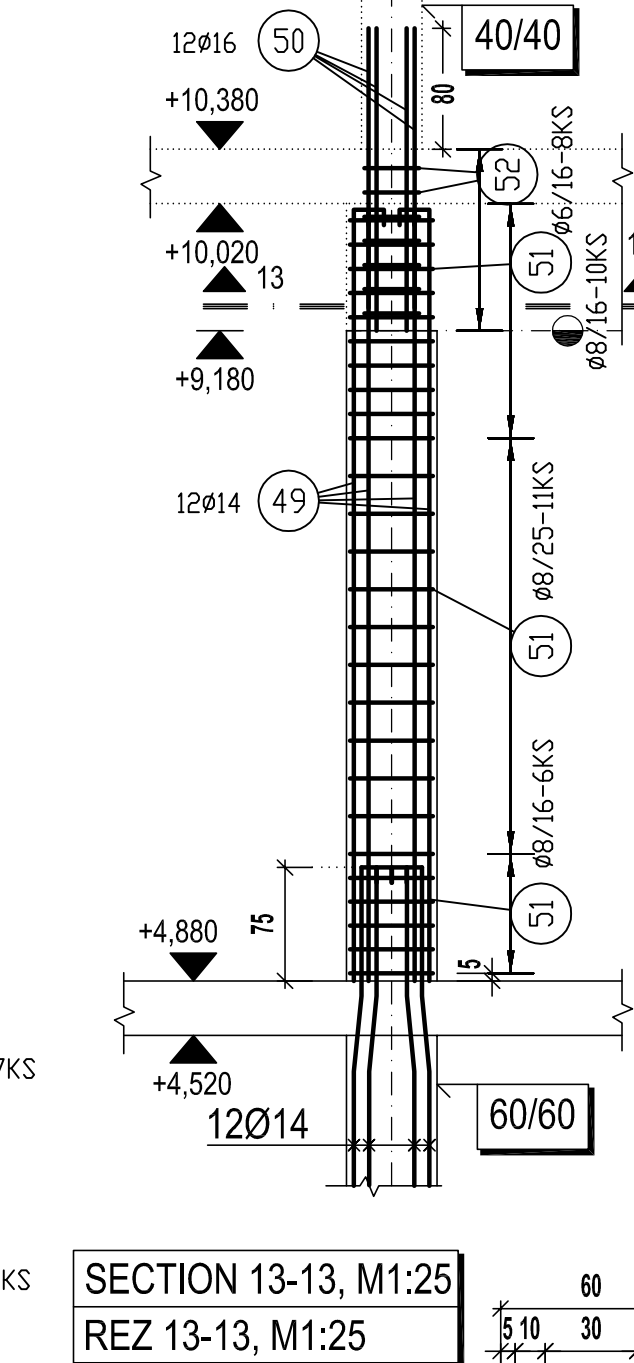

NOTES: (POZNÁMKY)

- Concrete grades (triedy betónu) (unless otherwise stated on the drawing - ak nie je uvedené na výkrese inak)
- Walls - (steny) C25/30
- Columns - (stĺpy) C30/37, C40/50 - SEE REINFORCEMENT DRAWING
- Slabs - (dosky) C30/37
- Beams - (nosníky) C30/37

- Inlay Work Drawings from GC3!


Concrete Quality / (trieda betónu) : as given on the drawing	Reference drawings / (odkaz na plány):
Reinforcing Steel / (rozsah ocele) : BS5500	GC3_P1_01_03_GF_F_SA_001-006
Concrete covering / (vrstva výstuže) : 3cm	GC3_P1_01_03_GF_F_CO_001-002
unless otherwise stated (ak nie je inak uvedené inak)	

15	15	dimensions in centimetre (kótované v cm)	construction joints (pracovná škára)
----	----	---	---

±0.00 = +139.75m Baltic sea after leveling

04	-	-	-
03	-	-	-
02	-	-	-
01	PO	DATE	DESCRIPTION

EUROVEA INTERNATIONAL
TRADE CENTER BRATISLAVA

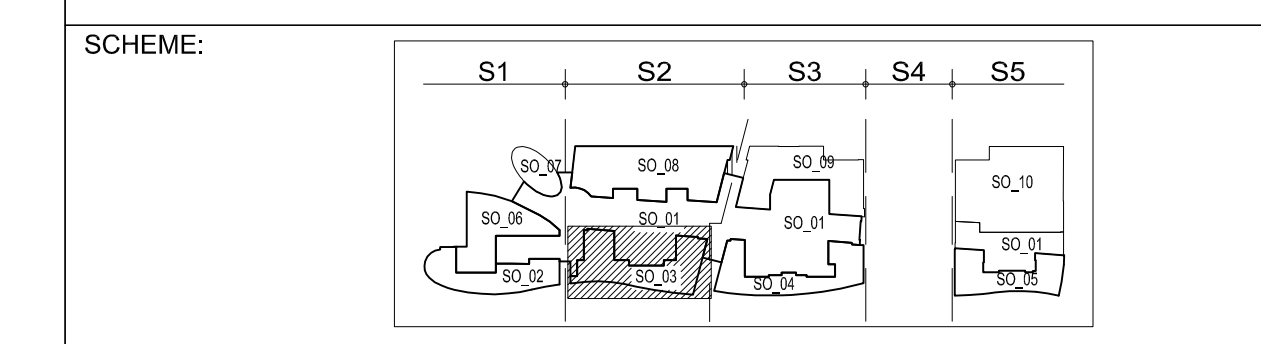

CLIENT:	DESIGNER:
Ballymore EUROVEA, a.s.	ZIPP BRATISLAVA s.r.o.
MOSTOVA 2, BRATISLAVA 811 02	ZIPPORECE SKUPINA
tel. +421 2 54640932, fax. +421 2 54640940	Stará Vajnarská 16
info@ballymore.sk	84 632-44 Bratislava
	ICO: 31365161
	DIČ: 200379691

TYPE OF DRAWING / (typ výkresu):	As Built
DRAWING TITLE / (názov výkresu):	(Projekt skutočného vyhotovenia)

COLUMNS REINFORCEMENT LEVEL 1 on AXIS I,J,K" and K/10,K/11,K/12,K/13
(VÝKRES VÝSTUŽE STĽPOV NA L1 na OSI I,J,K" a K/10,K/11,K/12,K/13)

PROJECT-NR.:	Company	Object	Detail of Object	Level	Discipline	Subject	Plan Number	Revision
XX-XXX	GC3	01	03	L1	R	CO	001	01
DATE:	SCALE:	FORMAT:	DESIGNED BY:	DRAWN BY:	CHECKED BY:			
2.12.07	1:50	0.99m²	BI	HR	BE			